




three inches = one foot
one and one half inches = one foot
one inch = one foot
three quarters inch = one foot
one half inch = one foot
three eighths inch = one foot
one quarter inch = one foot
one eighth inch = one foot

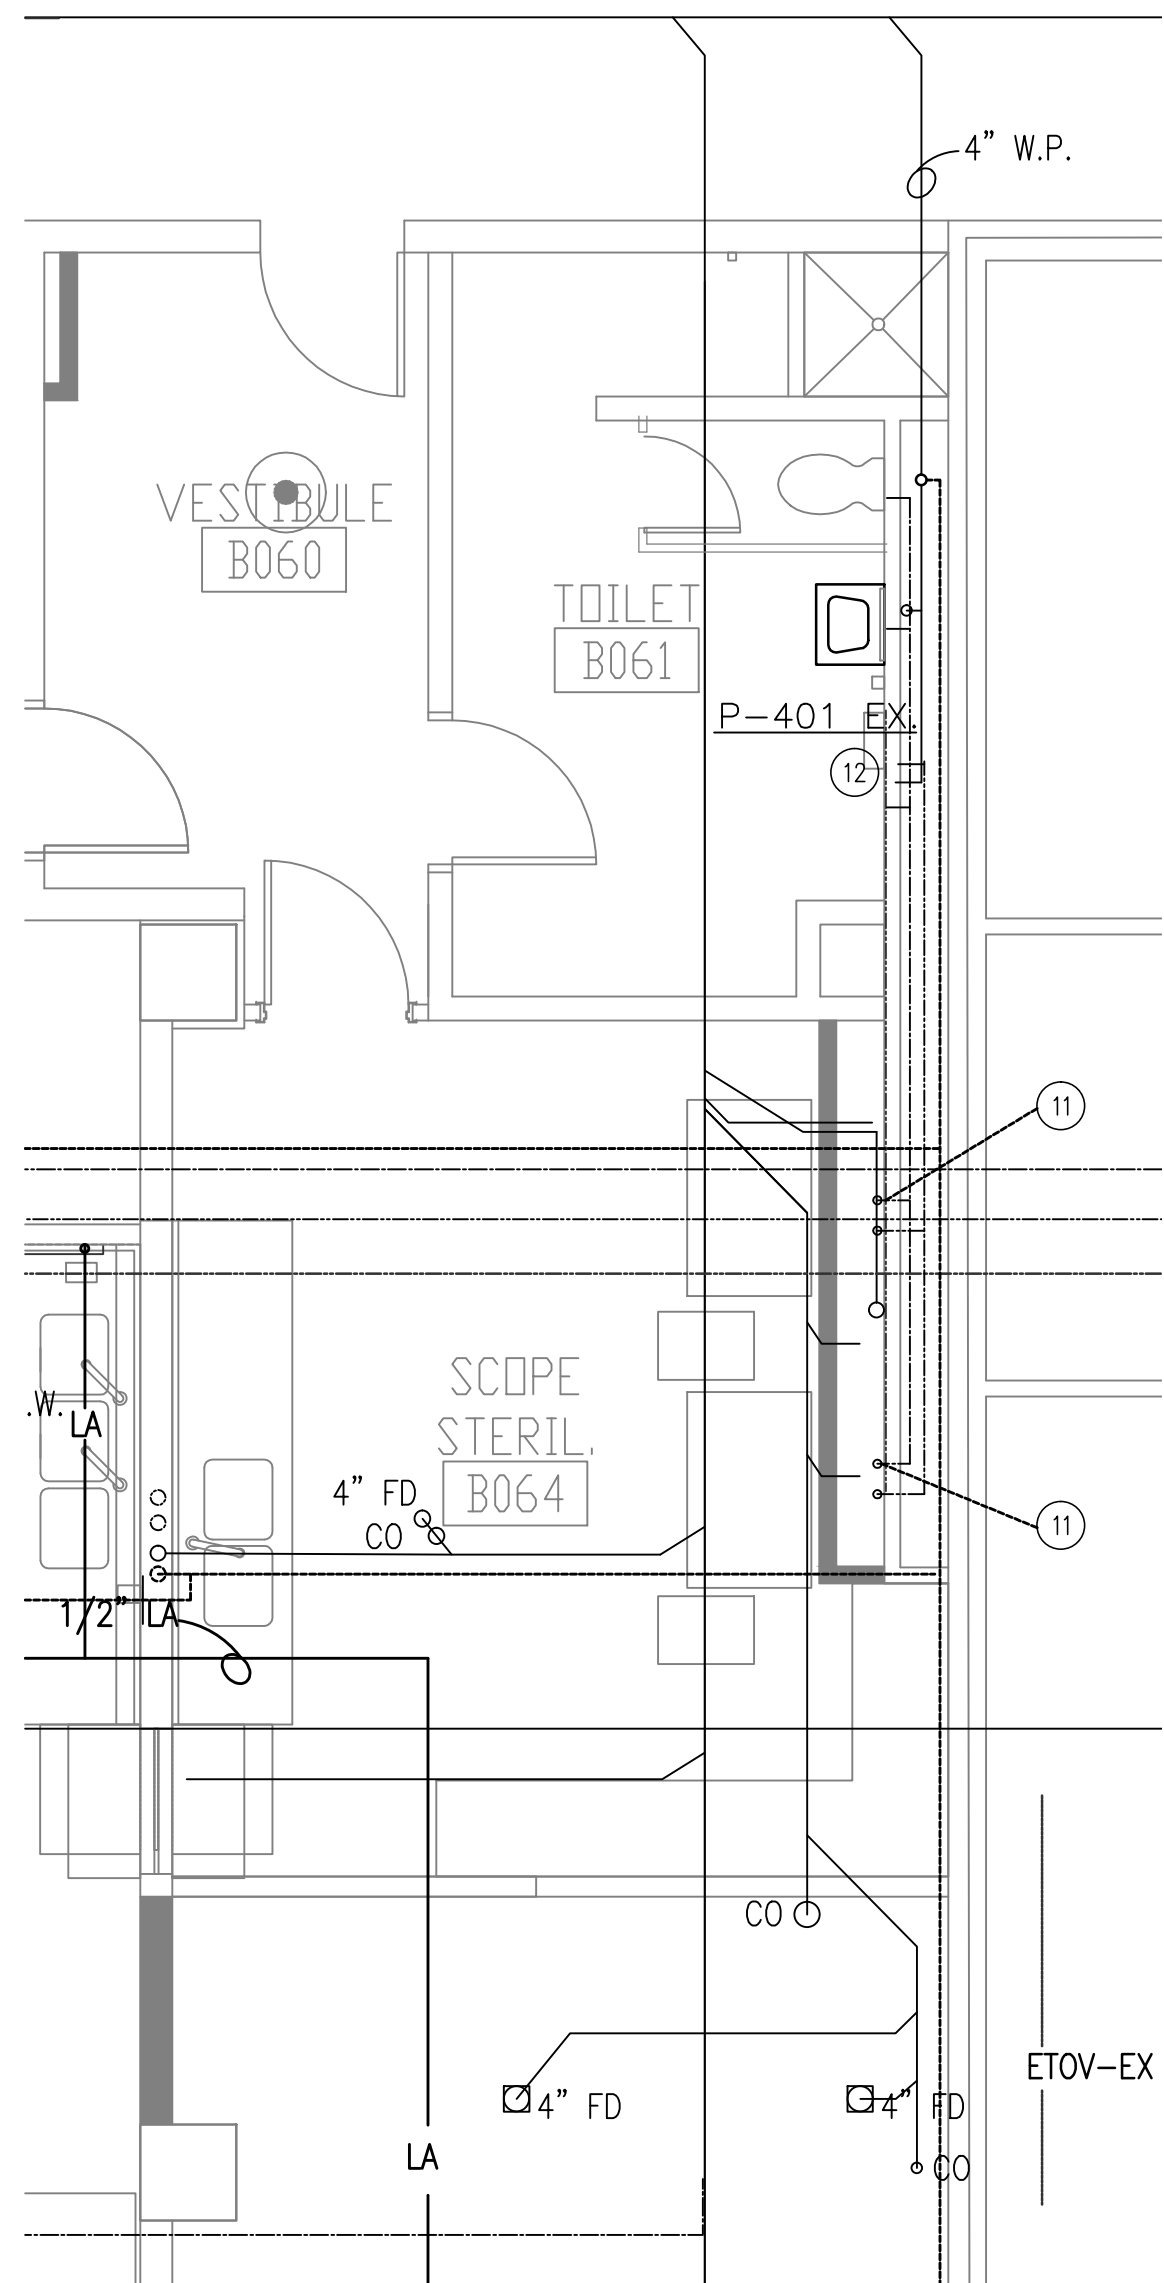

ENLARGED TOILET AND SCOPE INSTALLATION PLAN PHASE 2
SCALE: 1/4" = 1'-0"

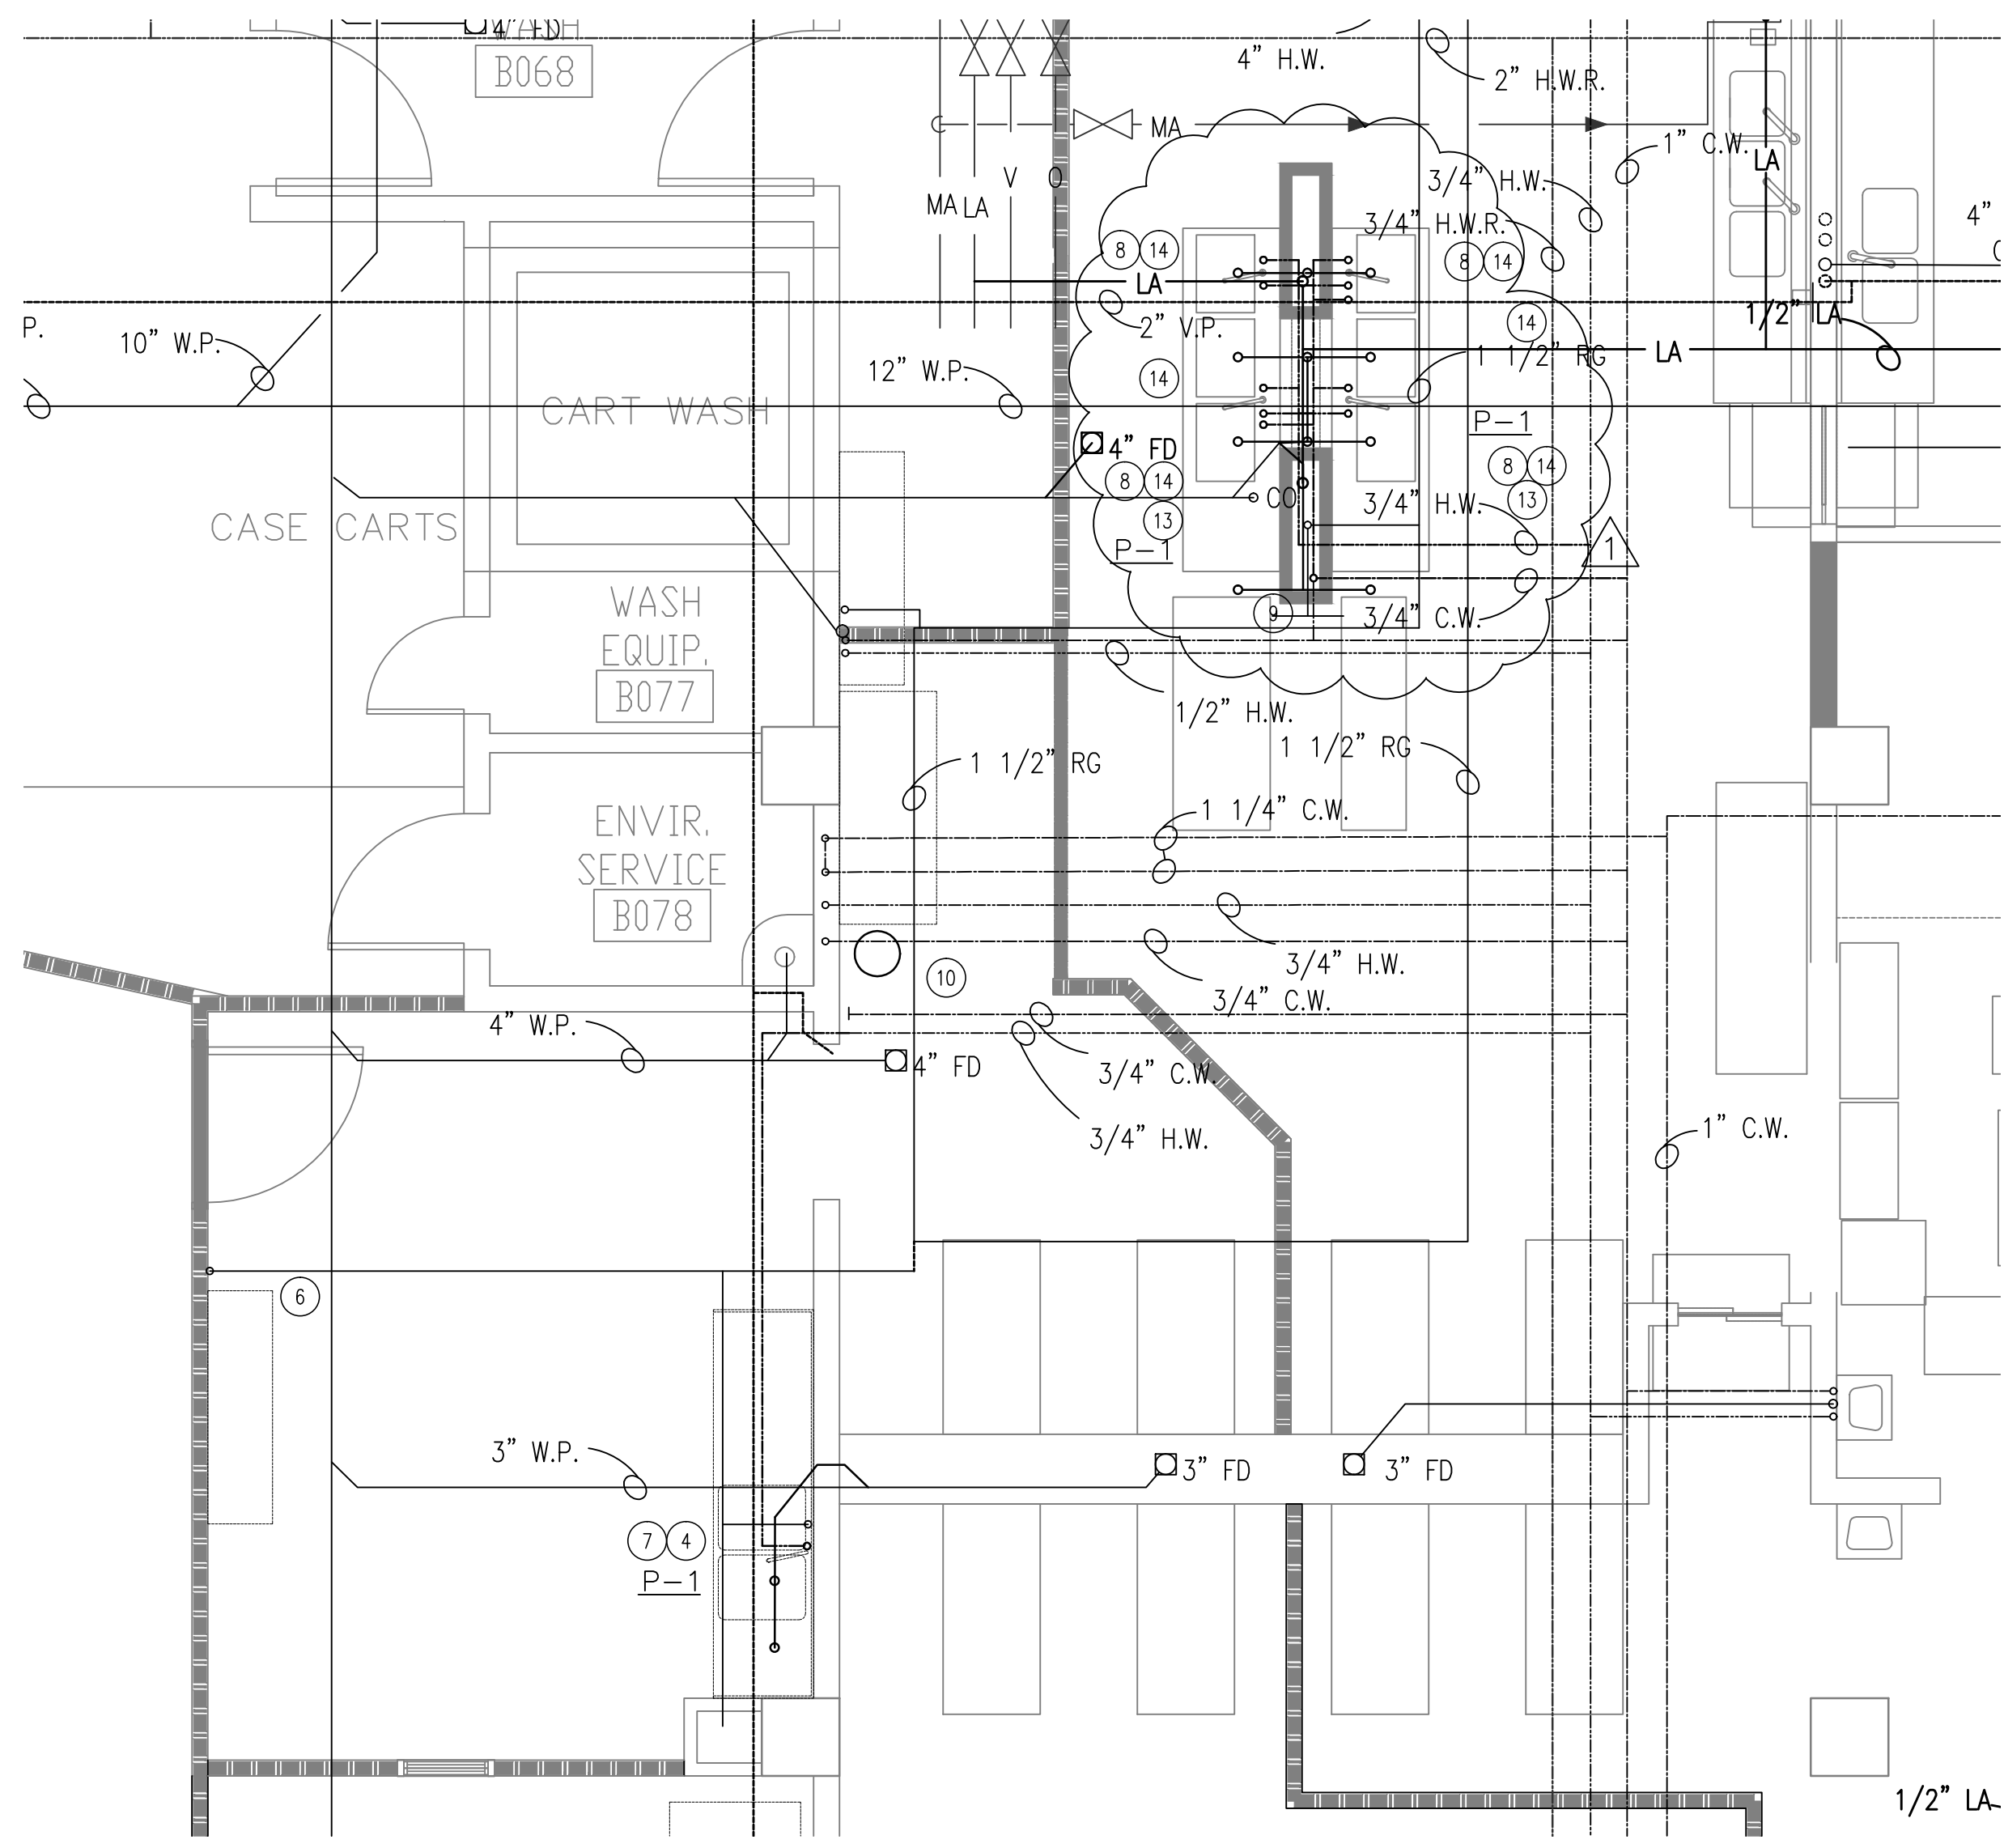

ENLARGED TEMPORARY DECONTAMINATION PLAN AND
DECONTAMINATION INSTALLATION PLAN PHASE 2
SCALE: 1/4" = 1'-0"

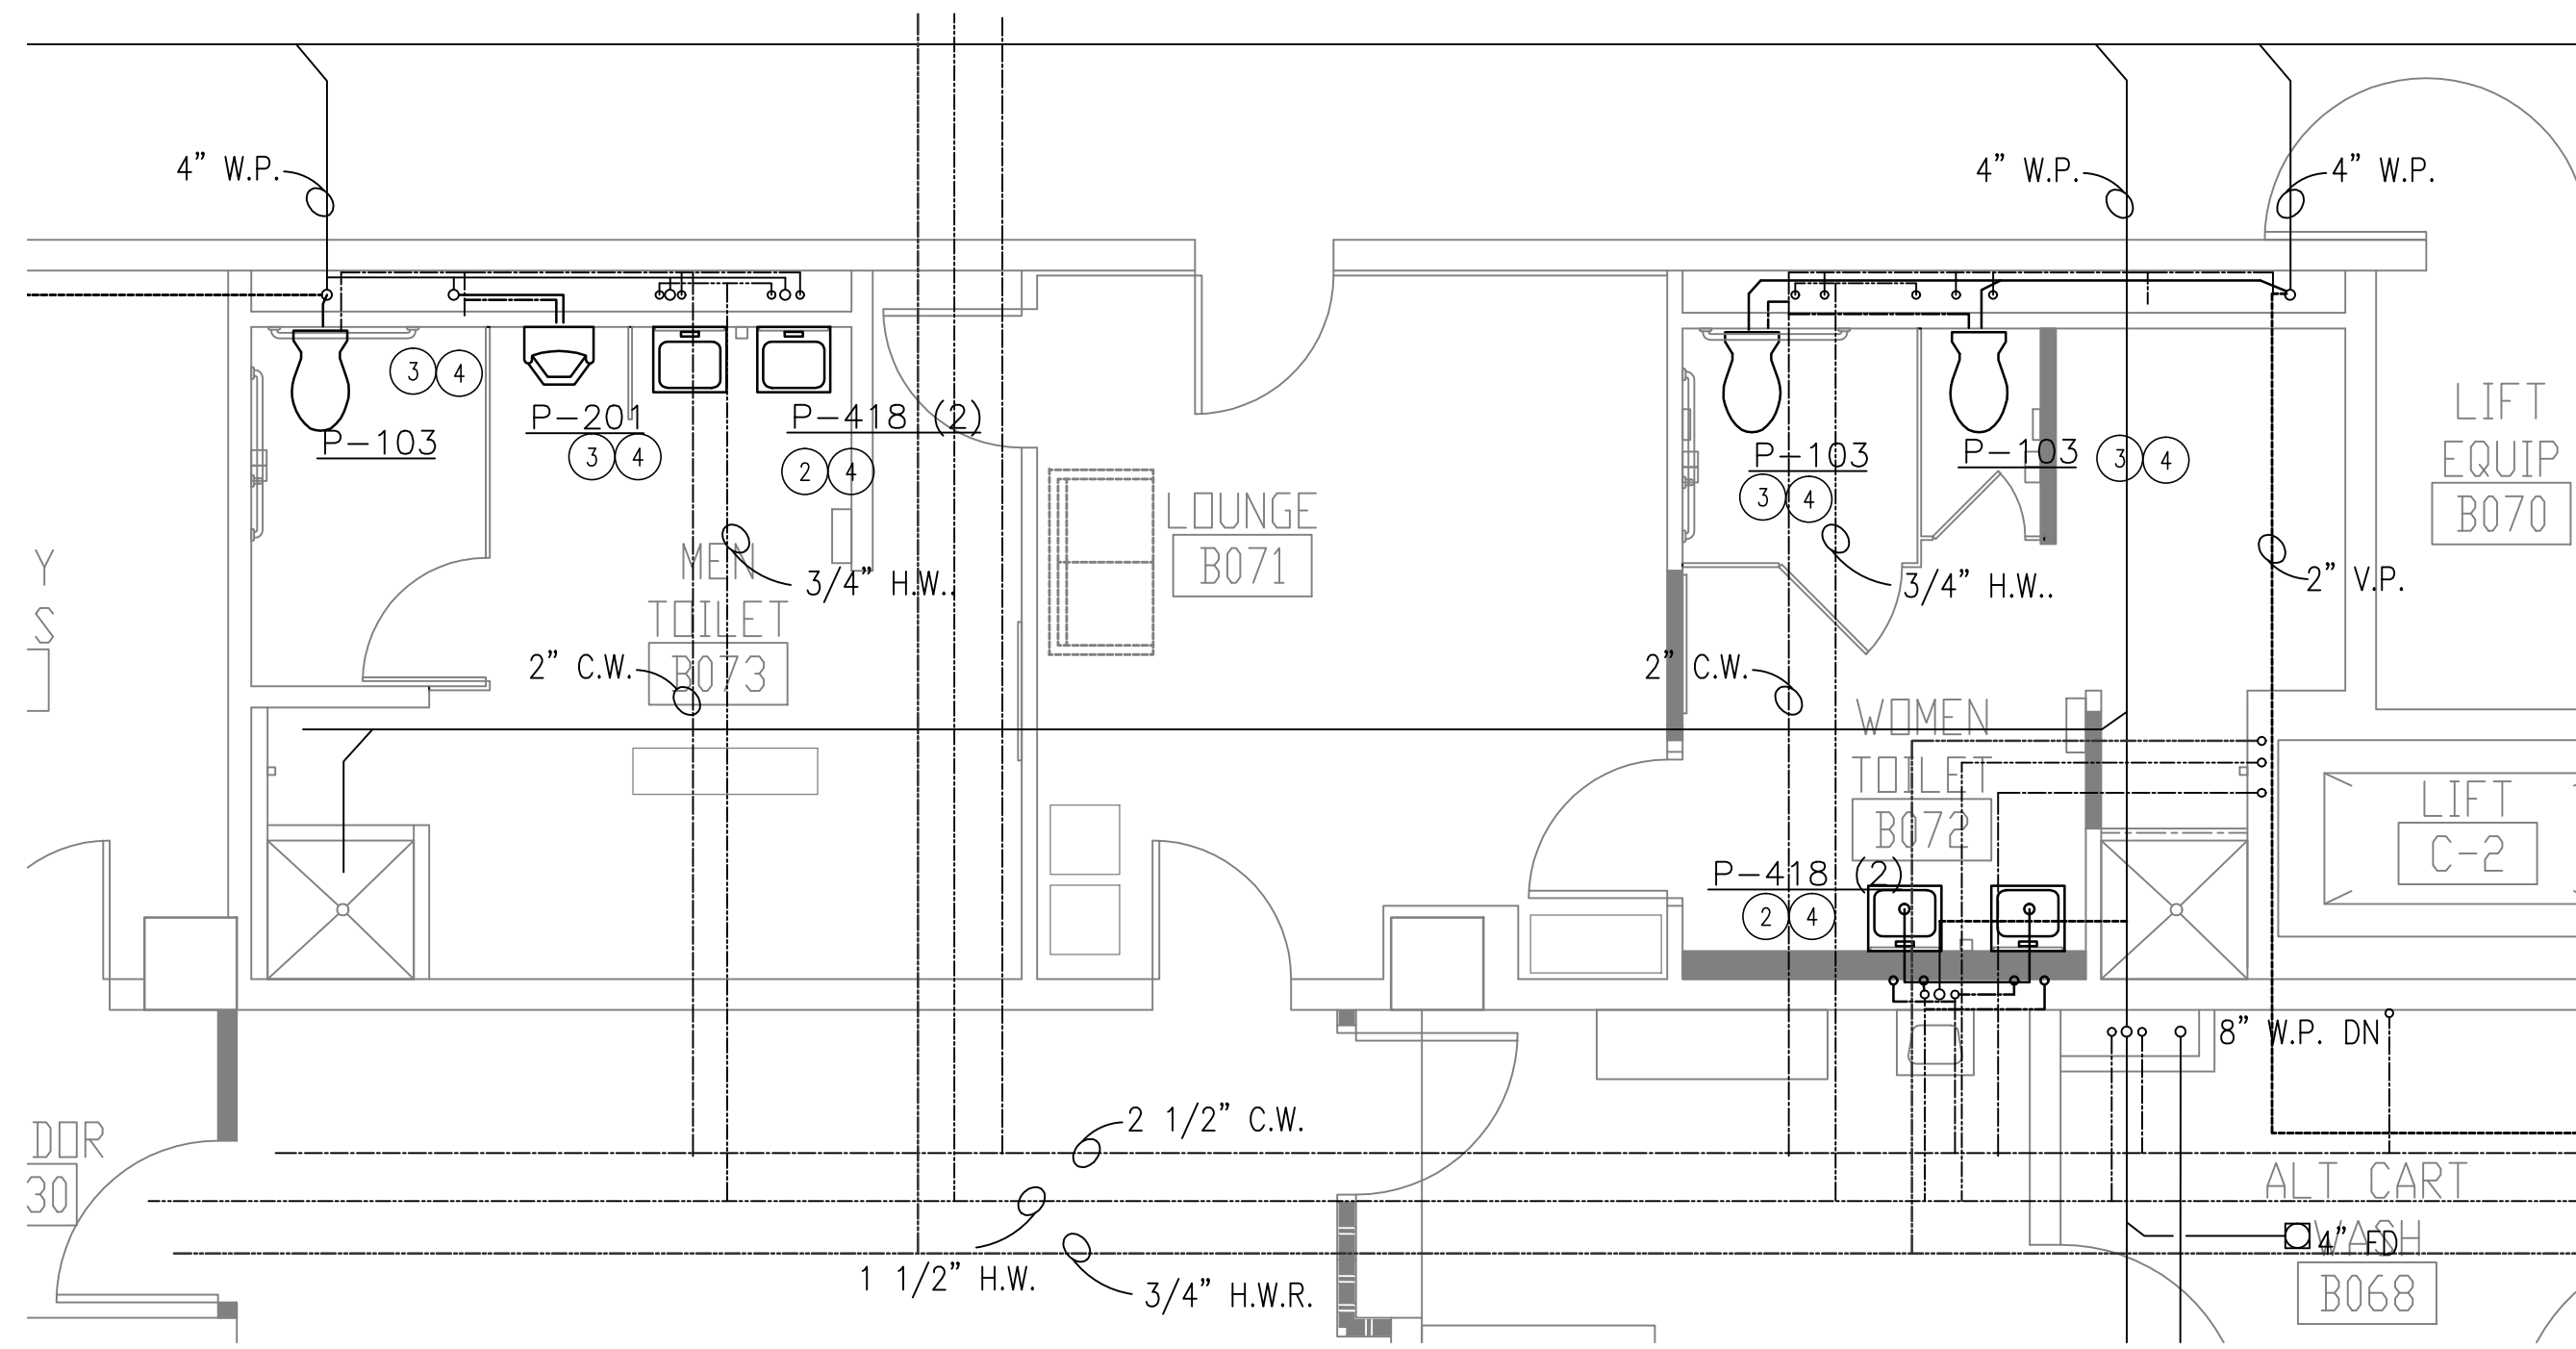

ENLARGED MENS AND WOMENS TOILETS PLANS PHASE 1
SCALE: 1/4" = 1'-0"

- GENERAL NOTES:
- DRAWING SHOWN REPRESENTING KNOWN CONDITIONS BASED ON EXISTING REFERENCE DRAWINGS AND OTHER ONGOING PROJECTS RELATED TO DOMESTIC WATER. CONTRACTOR TO VERIFY EXISTING CONDITIONS AND COORDINATE WORK WITH OTHER KNOWN OR UNKNOWN RISER RENOVATION PROJECTS
 - ANY SITE MODIFICATION NOT SHOWN ON DRAWINGS SHALL BE MARKED-UP ON AN EXISTING DRAWING. CONTRACTOR SHALL SUBMIT A MARKED UP SET TO THE VA COR FOR AS-BUILT PURPOSES AT THE CONCLUSION OF THE PROJECT.
 - PLUG, FULLY CLOSE AND REMOVE HANDLE FROM ALL UNUSED MEDICAL GAS VALVES.
 - FOR SYMBOLS AND ABBREVIATIONS SEE DRAWING G004
 - SEE DRAWING PL-500 FOR DETAILS AND EQUIPMENT SCHEDULES.

- PLAN NOTES PHASE 1:
- SEE DRAWING PD-100 FOR DEMOLITION OF FIXTURES AND PIPING WORK
 - CONNECT 1/2" DOMESTIC COLD WATER, HOT WATER PIPING TO SINKS SHOWN ON PLAN.
 - CONNECT 1 1/2" DOMESTIC COLD WATER TO TOILET AND 3/4" FOR URINAL SHOWN ON PLAN.
 - CONNECT NEW OR RE-CONNECT SANITARY SEWER, (S.S.) AND VENT PIPING (V.P.)
- PLAN NOTES PHASE 2:
- SEE DRAWING PD-101 FOR DEMOLITION OF FIXTURES AND PIPING WORK
 - CONNECT NEW 1/2" REAGENT WATER (RG) FOR TEMPORARY ULTRASONICS LOCATION AS INDICATED.
 - CONNECT 1/2" DOMESTIC C.W. AND DOMESTIC H.W. WITH FILTRATION FOR TEMP SINKS LOCATIONS ON TEMPORARY DECONTAMINATION.
 - CONNECT 1/2" DOMESTIC C.W. AND DOMESTIC H.W. FOR CENTER STATION SINK IN LOCATIONS IN DECONTAMINATION AS INDICATED.
 - CONNECT NEW 1/2" REAGENT WATER (RG) FOR NEW ULTRASONICS LOCATION AS INDICATED.
 - CONNECT C.W. AND DRAIN FOR EYEWASH AND SHOWER STATION
 - CONNECT C.W. AND H.W. IN SCOPE STERILIZATION ROOM. TMV TO REMAIN ACCESSIBLE.
 - CONNECT C.W., H.W. AND RECONNECT VENT AND DRAINS TO SINKS AS REQUIRED
 - CONNECT LABORATORY AIR FOR CENTER SINK LOCATION IN DECONTAMINATION AS INDICATED.
 - CONNECT NEW DRAINS WITH SUPPLIED SINK FLEXIBLE DRAIN BELLOWS. CONNECT WITH ALL REQUIRED ADAPTERS, FITTINGS, AND PIPE JOINING MATERIAL AS RECOMMENDED PER MANUFACTURER.


SCHEMATIC DESIGN-ALT. 1 FIRST REVIEW	10/19/2012
35% SD REVISION 1	11/28/2012
65% DD SUBMITTAL	12/20/2012
95% CD SUBMITTAL	01/30/2013
100% CD SUBMITTAL	02/27/2013
BIDDING DOCUMENTS	06/10/2013
AMENDMENT 2	8-2-2013
Revisions	Date



Dept. of Veterans Affairs
Richard L. Roudebush
VA Medical Center
1481 W. 10th Street
Indianapolis, In 46202

CERTIFIED BY:

NORTH REFERENCE

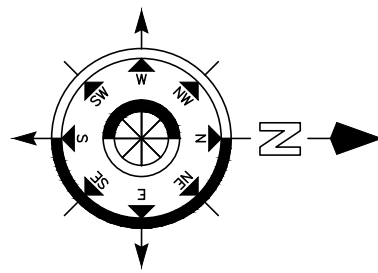

ARCHITECT/ENGINEERS:

9245 Calumet Ave, Suite 205,
Munster, IN 46321
(219) 836-2120 Fax (219) 836-1129



Drawing Title
PLUMBING ENLARGED INSTALLATION PLANS
PHASE 1 AND 2

PROJECT ENGINEER
John Piwowarski

Approved Engineering Chief

SCALE

Approved Service Chief

Project Title
RENOVATE SPS

Location
BASEMENT A-WING

Date
6/10/2013

Checked
DS

Drawn
DR

Project Number
583-12-107

Building Number
1

Drawing Number
PL400

3FY12

25 of 55

BIDDING DOCUMENTS
FULLY SPRINKLERED

Engineering
and Facilities
Management
Services

